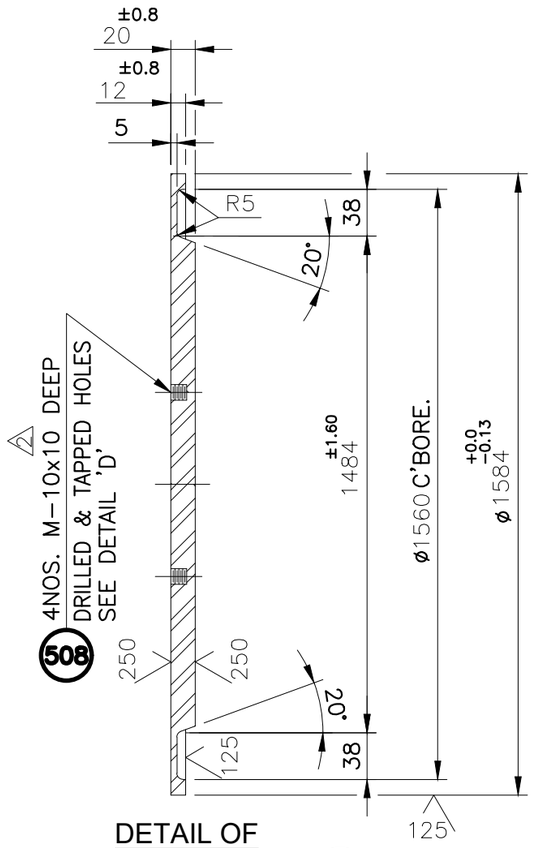

DETAIL OF
GASKET RETAINER 125

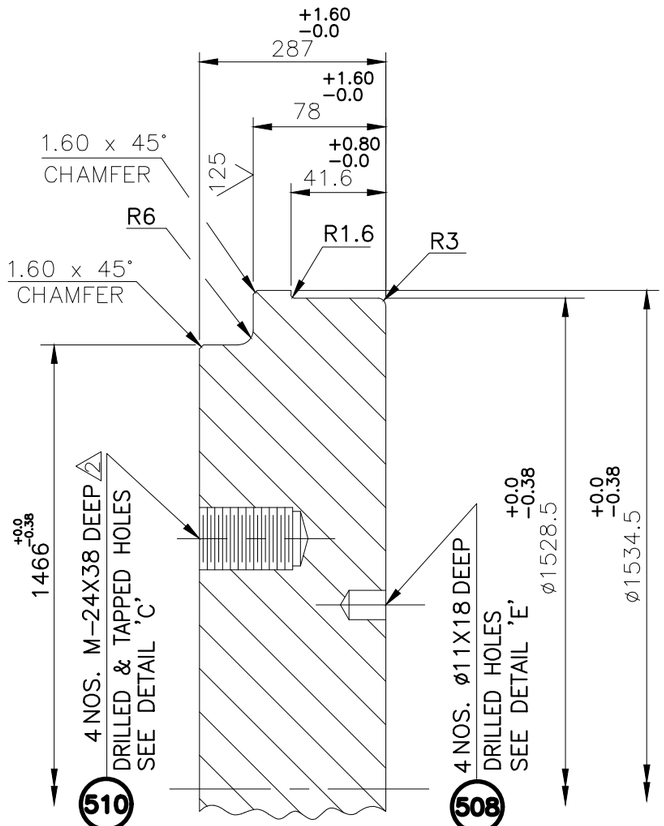

250 RMS FINISH ALL OVER
EXCEPT WHERE NOTED

DETAIL OF
CHANNEL COVER 204

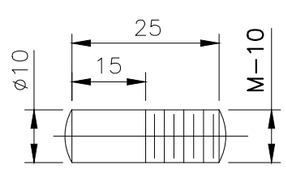

DETAIL OF STUD 508

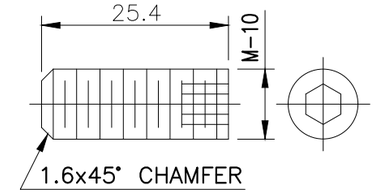

CENTERING SET SCREW
HEXAGON SOCKET
SET SCREW WITH FLAT POINT END 509

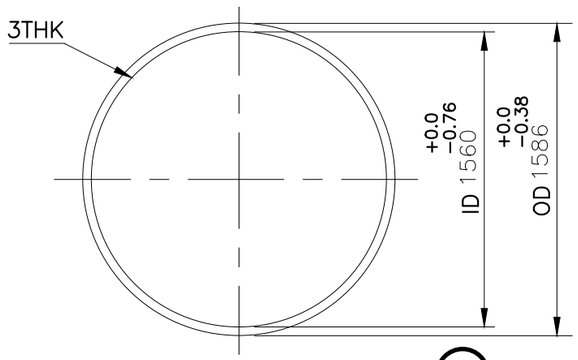

DETAIL OF RING GASKET 402

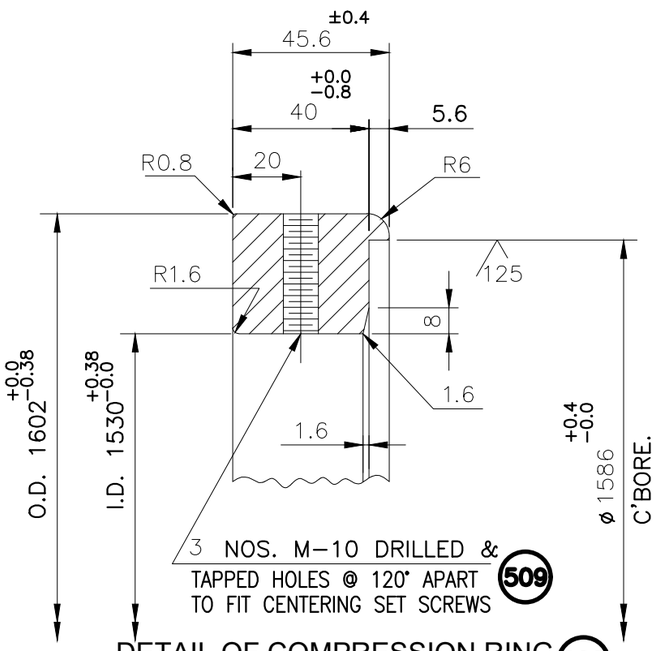

DETAIL OF COMPRESSION RING 208

250 RMS FINISH ALL OVER
EXCEPT WHERE NOTED

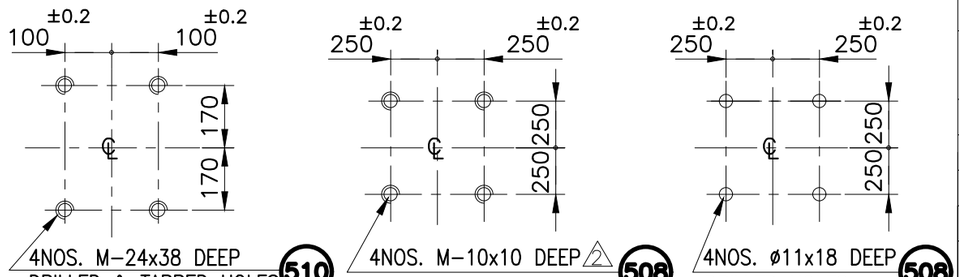

DETAIL "C"

DETAIL "D"

DETAIL "E"

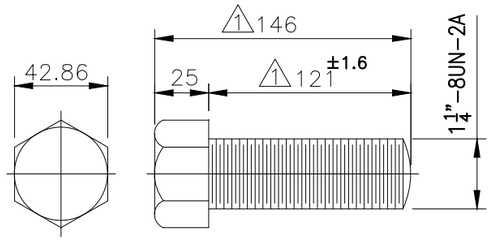

DETAIL OF
HEX HEAD SET SCREWS 505

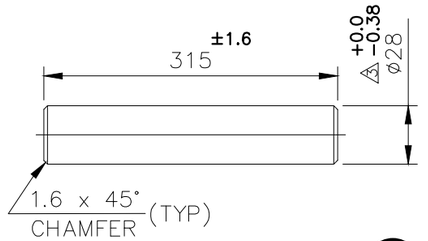

DETAIL OF PUSH ROD 603

125 RMS FINISH OR BETTER ALL OVER
MUST BE STRAIGHT WITHIN 0.38

DRAWING CERTIFIED BY
Harry R. Bishop 05/26/03
HARRY R. BISHOP
CHIEF DESIGN ENGINEER

4 "AS BUILT DWG"

REV.	DATE	DESCRIPTION	DRWN	CHKD	APPD
4	05/26/03	AS BUILT DIMENSIONS ARE SHOWN IN BKT (–) & OTHER REVISED AS MKD 4 THUS	DMF	WB	HRB
3	04/17/02	DWG IS REVISED AS MKD. 3 THUS.	DMF	WB	HRB
2	03/28/02	DWG IS REVISED AS MKD. 2 THUS.	DMF	WB	HRB
1	03/13/02	DWG IS REVISED AS MKD. 1 THUS.	DMF	WB	HRB
0	02/08/02	SUBMITTAL FOR APPROVAL	DMF	WB	HRB

PROJECT NAME : **CPCL REFINERY- III PROJECT**

MANUFACTURER : TEMA INDIA LTD
Factory: Achhad Village, Dist. Thane, & Kherdi, Silvassa Gram: CODEDVESEL Mumbai 88.

ENGINEERING : Struthers **STRUTHERS INDUSTRIES, INC. GULFPORT, MISSISSIPPI**

CONSULTANT : **ENGINEERS INDIA LIMITED**

CLIENT : **CHENNAI PETROLEUM CORPORATION LIMITED**

TITLE : **DETAIL OF CHANNEL INTRNAL CLOSURE PARTS. RX EFFLUENT / CLPS LIQUID** 1

EQPT. NO. 207-E4

JOB NO.	SII	3-02-04-41206B	P/O No.	1027/PO/2138/4814		
	TEMA	T/E/02517				
SCALE	NTS	DWG. No. or Doc No.	VP-1027-E4-02517	SHT. NO.	Rev.	
				10 OF 18	1 2 3 4	