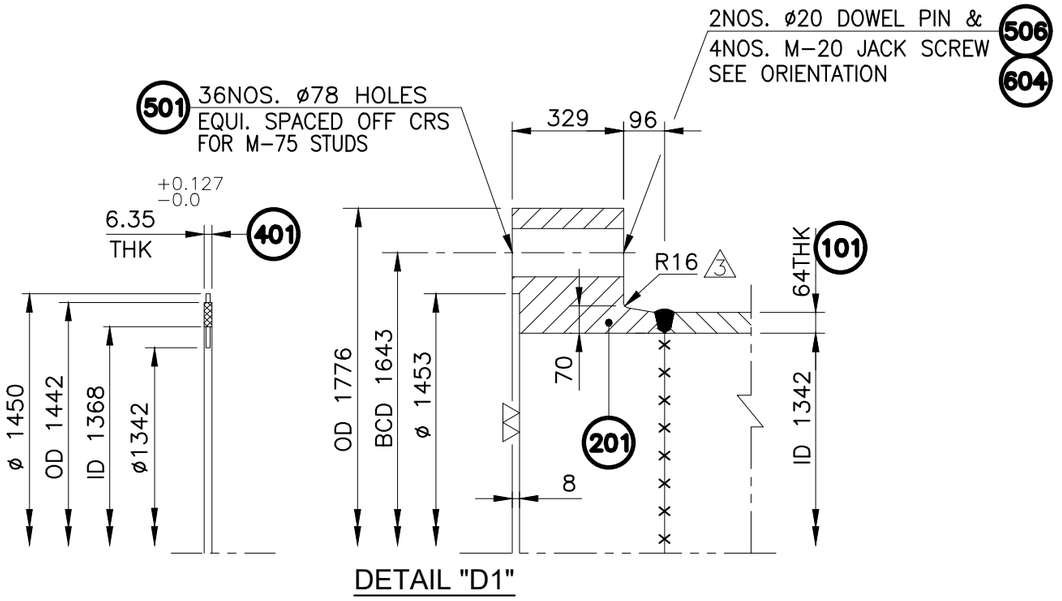

DETAIL "D1"

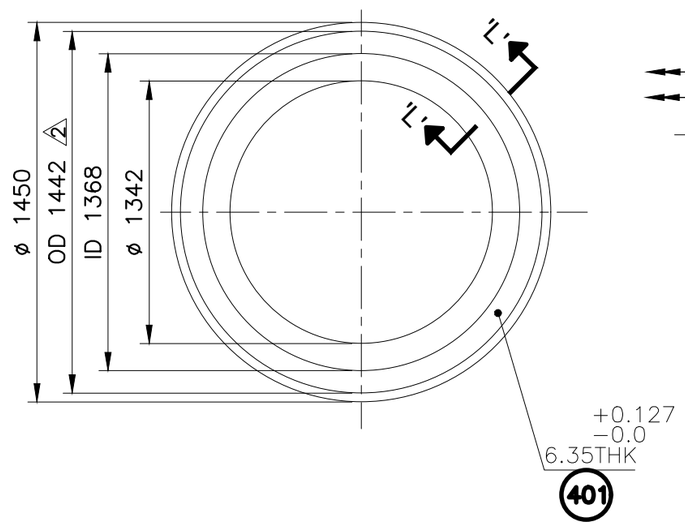

DETAIL OF GASKET FOR TUBESHEET TO SHL. FLG. 1

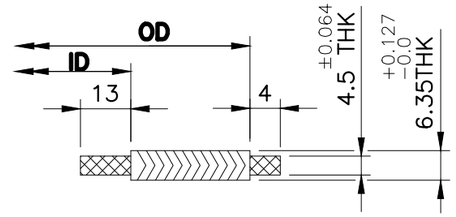

SECTION:'L-L'

DRAWING CERTIFIED BY
Harry R. Bishop 05/26/03
HARRY R. BISHOP
CHIEF DESIGN ENGINEER

● = JACK SCREW
○ = DOWEL PIN

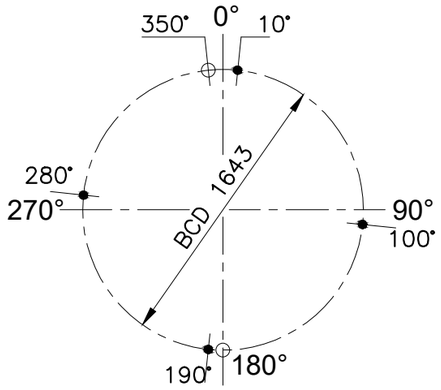

ORIENTATION FOR JACKSCREW & DOWEL PIN

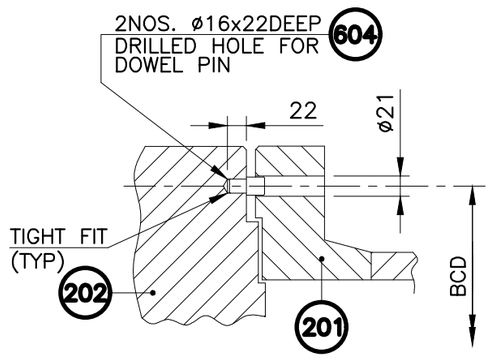

DETAIL OF DOWEL PIN ARRANGEMENT

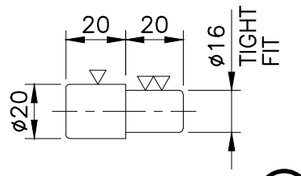

DETAIL OF DOWEL PIN 604

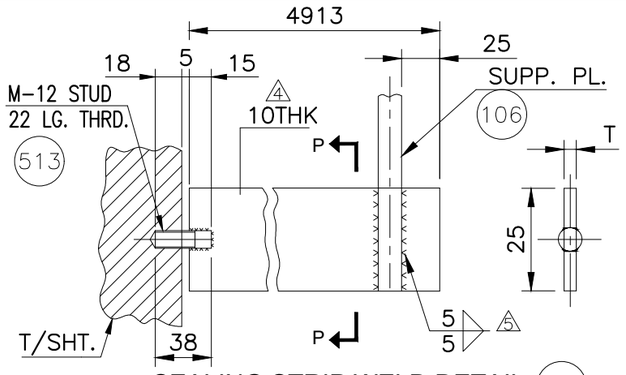

SEALING STRIP WELD DETAIL 118

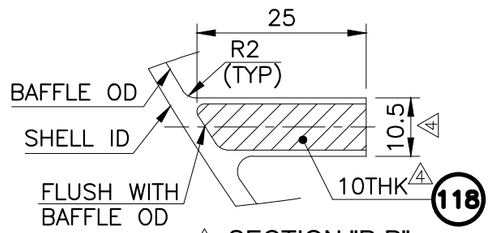

1 SECTION "P-P"

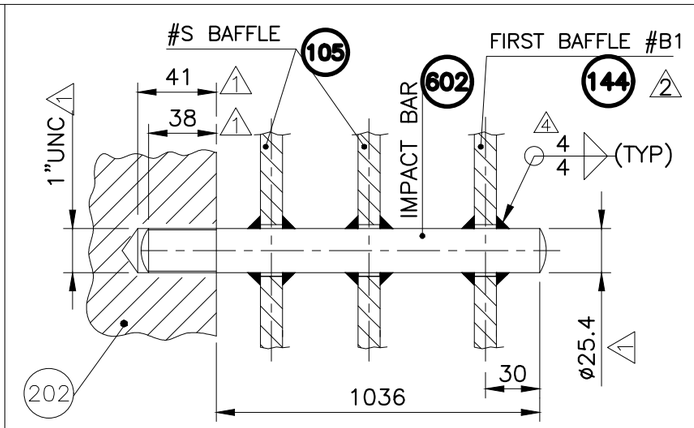

DETAIL OF IMPACT BAR WELD 2

REV.	DATE	DESCRIPTION	DRWN	CHKD	APPD
6	05/26/03	AS BUILT DIMENSIONS ARE SHOWN IN BKT (–) & OTHER REVISED AS MKD 6 THUS	DMF	WB	HRB

PROJECT NAME : **CPCL REFINERY- III PROJECT**

MANUFACTURER : **"AS BUILT DWG"** 6 — TEMA INDIA LTD
Factory: Achhad Village, Dist. Thane, & Kherdi, Silvassa Gram: CODEDIESEL Mumbai 88.

ENGINEERING : Struthers — **STRUTHERS INDUSTRIES, INC. GULFPORT, MISSISSIPPI**

CONSULTANT : **ENGINEERS INDIA LIMITED**

CLIENT : **CHENNAI PETROLEUM CORPORATION LIMITED**

TITLE : **DETAIL OF GIRTH FLG., GASKET, JACK SCREW RX EFFLUENT / CLPS LIQUID** 1 — **EQPT. NO. 207-E4**

JOB NO.	SII	3-02-04-41206B	P/O No.	1027/PO/2138/4814	
	TEMA	T/E/02517			
SCALE	NTS	DWG. No. or Doc No.	VP-1027-E4-02517	SHT. NO.	Rev.
				15 OF 18	3 4 5 6

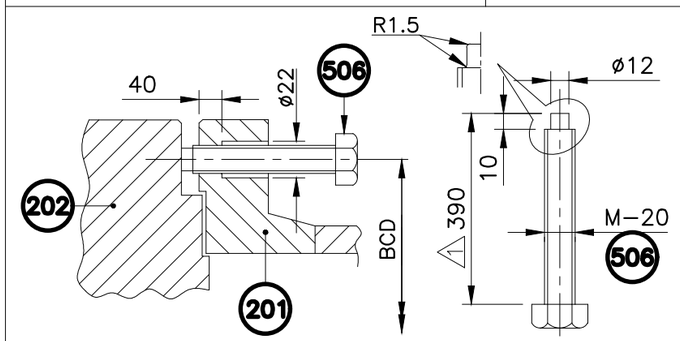

DETAIL OF JACK SCREW ARRANGEMENT

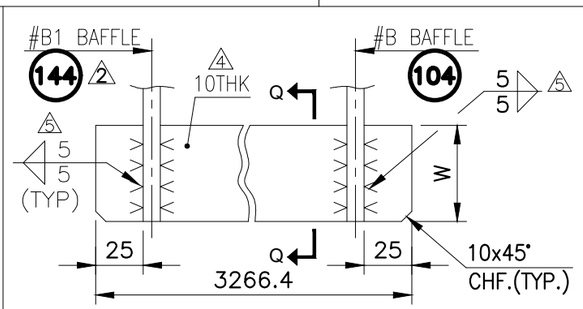

DETAIL OF SEALING STRIP WELD 1

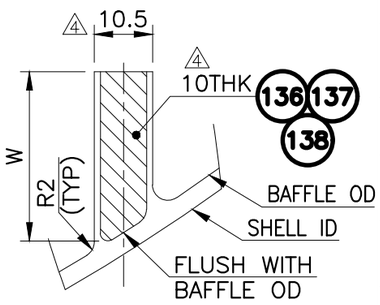

SECTION "Q-Q" 1